



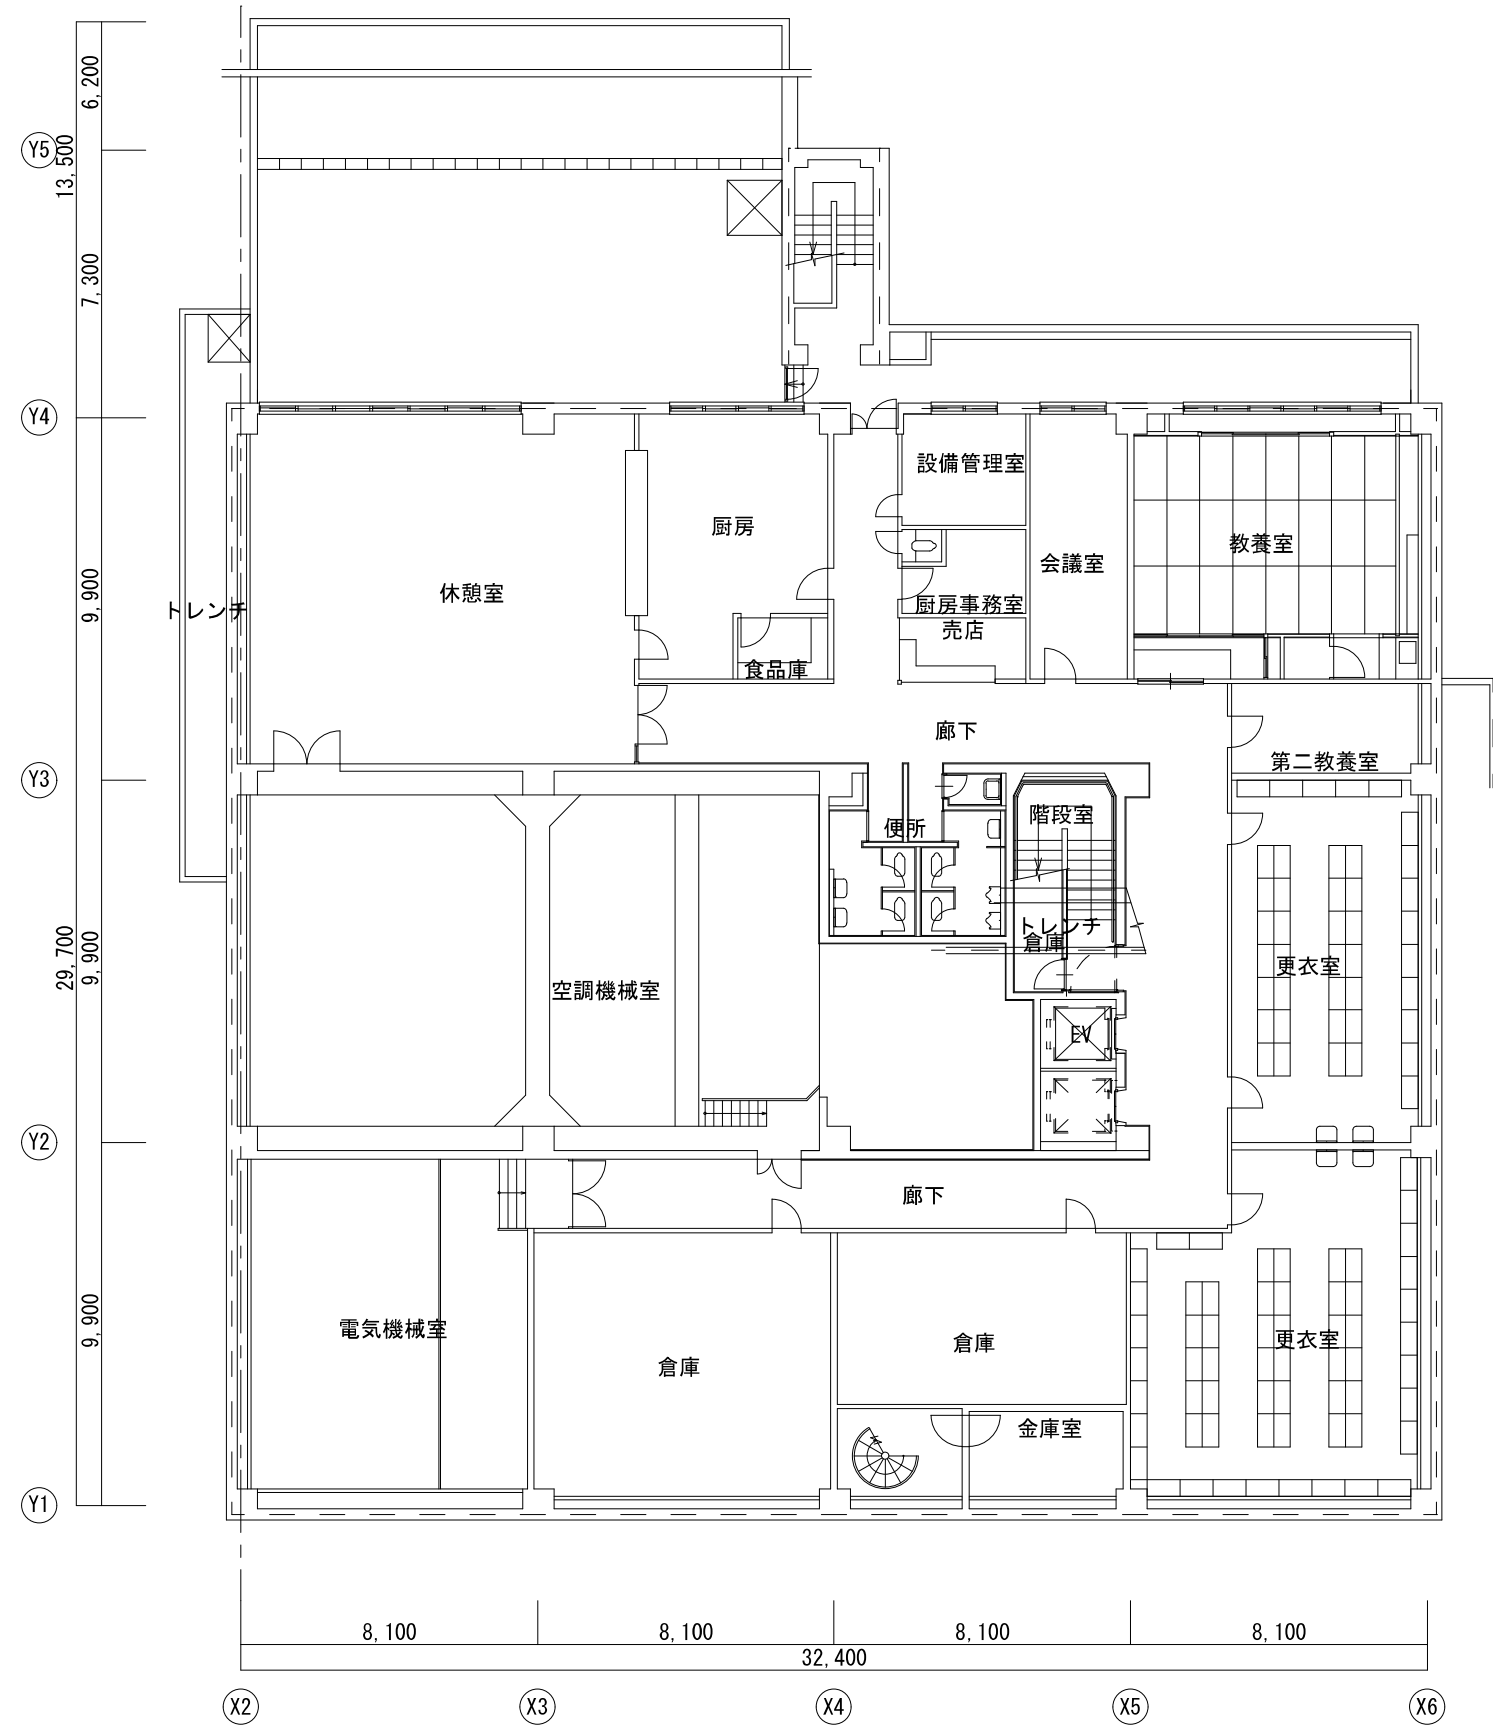


B1階 平面図 S=1/200

竣工図

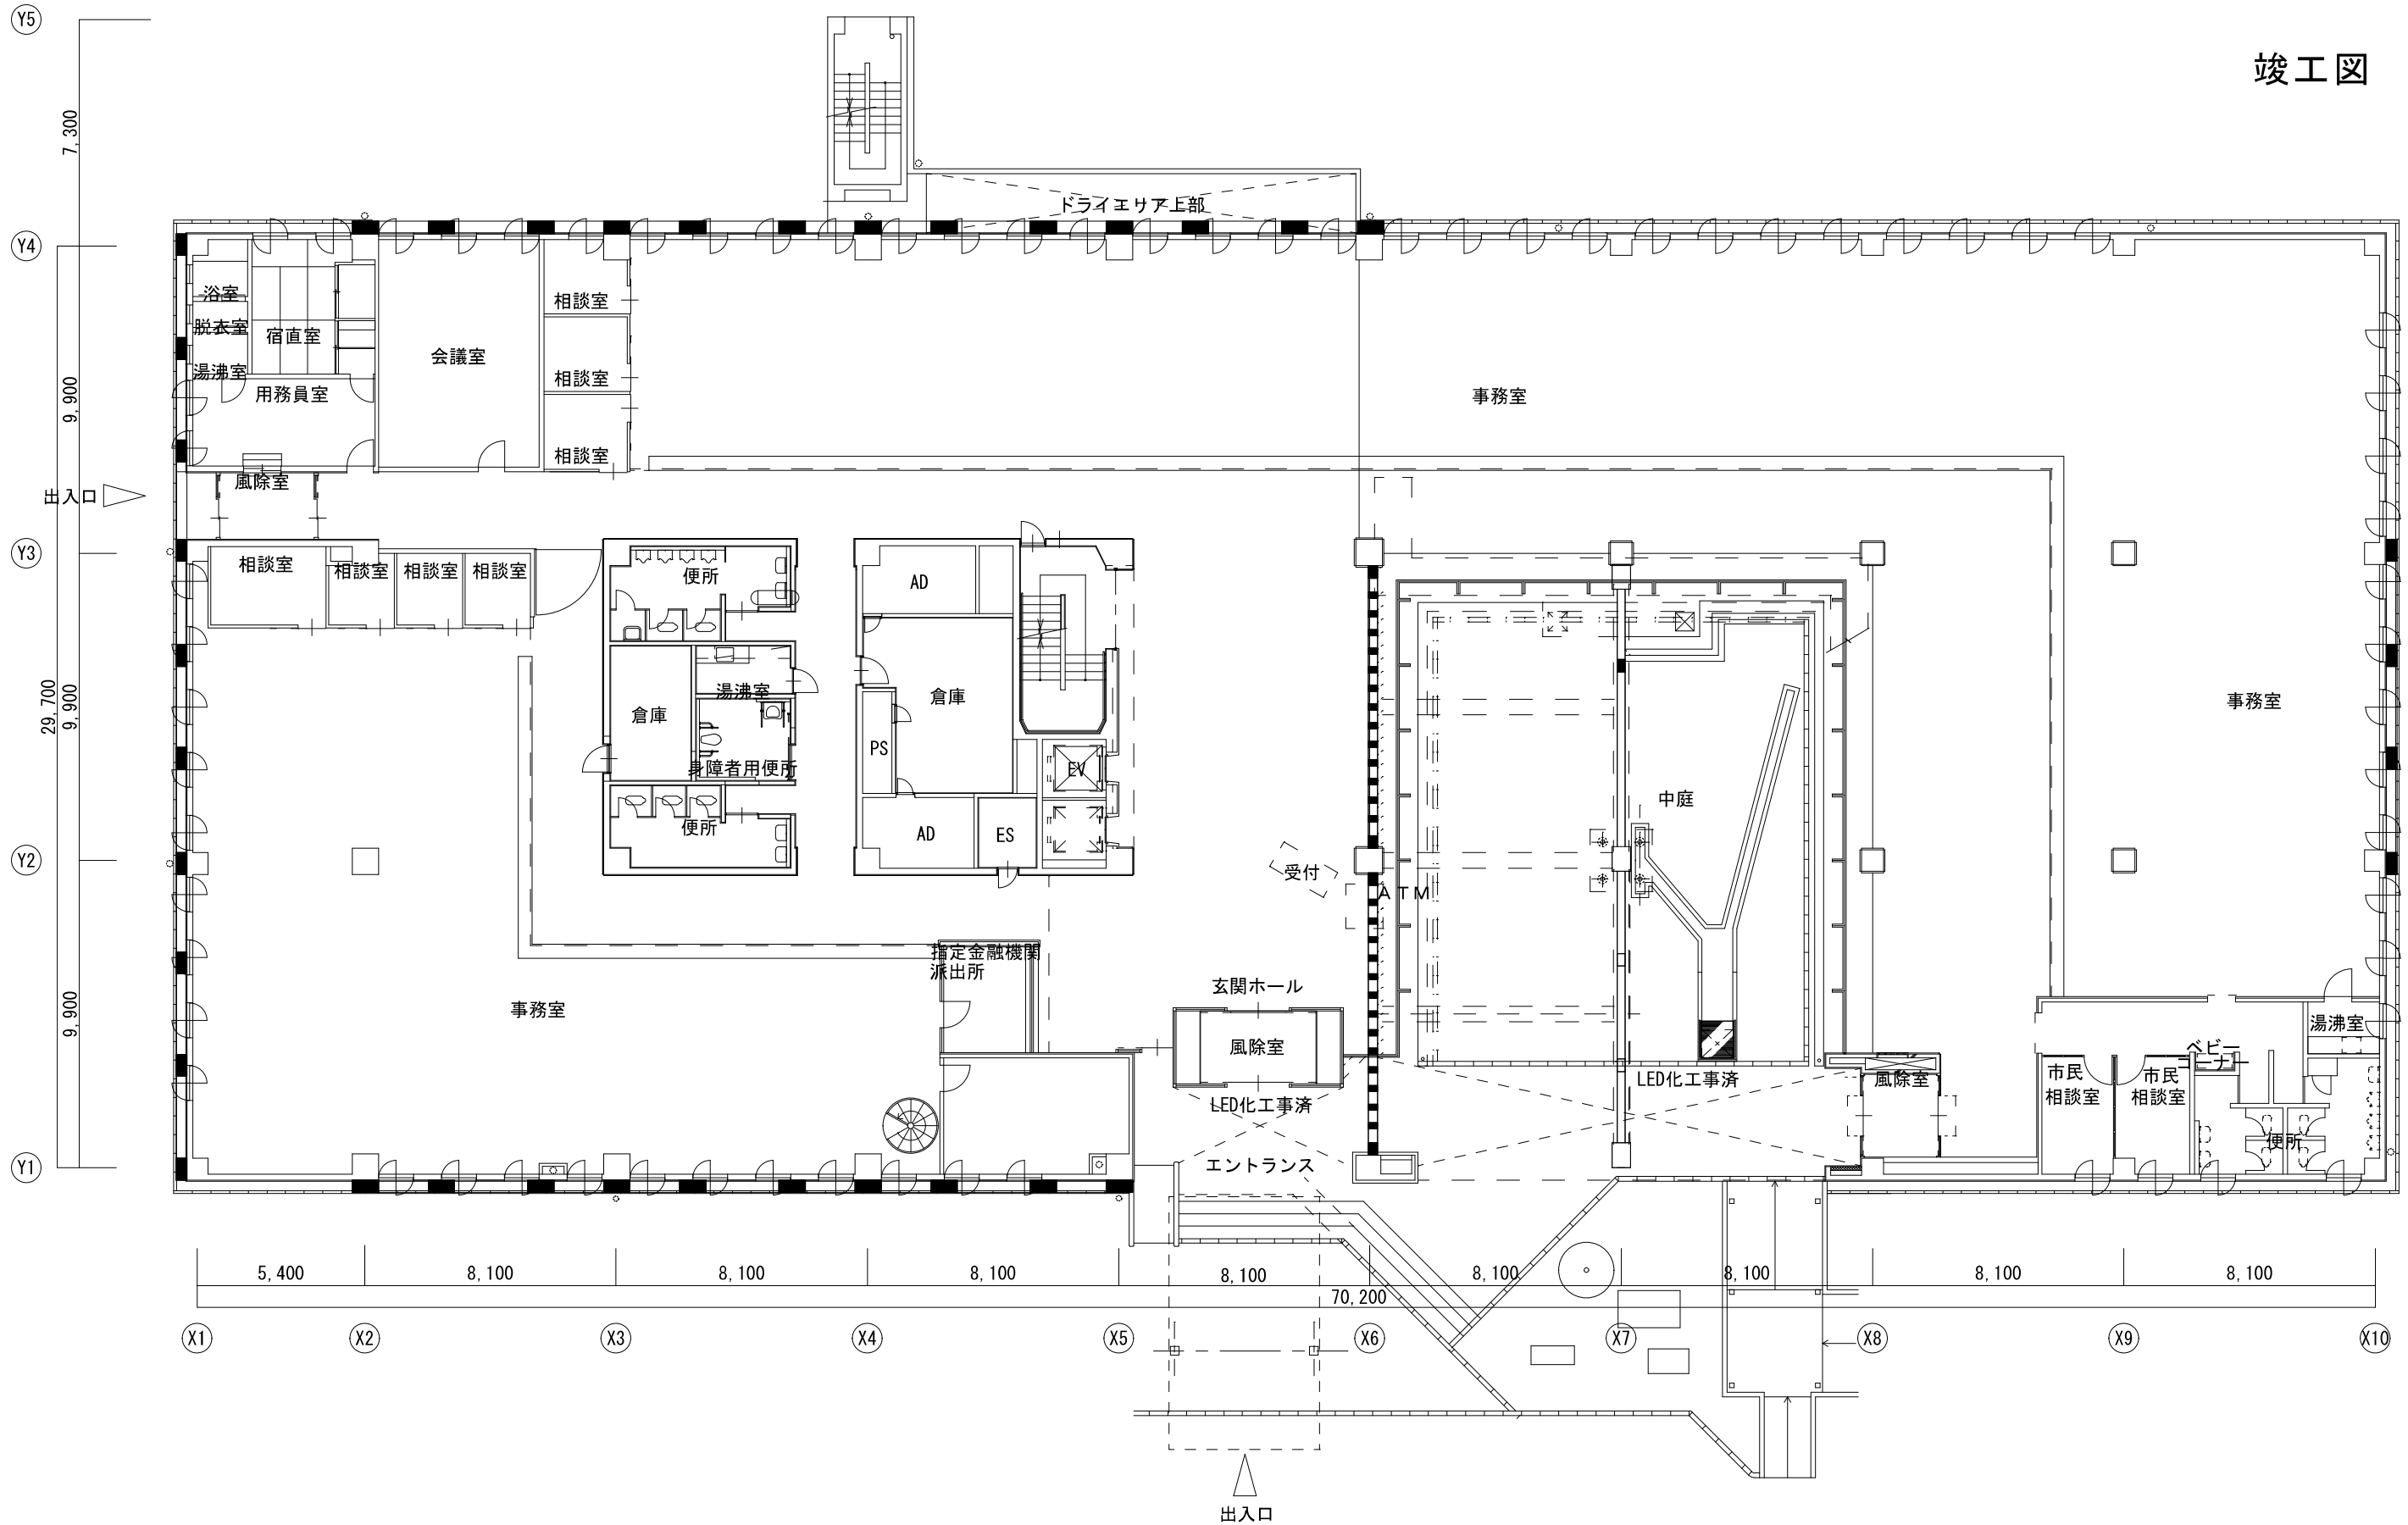


1階 平面図 S=1/200

竣工図

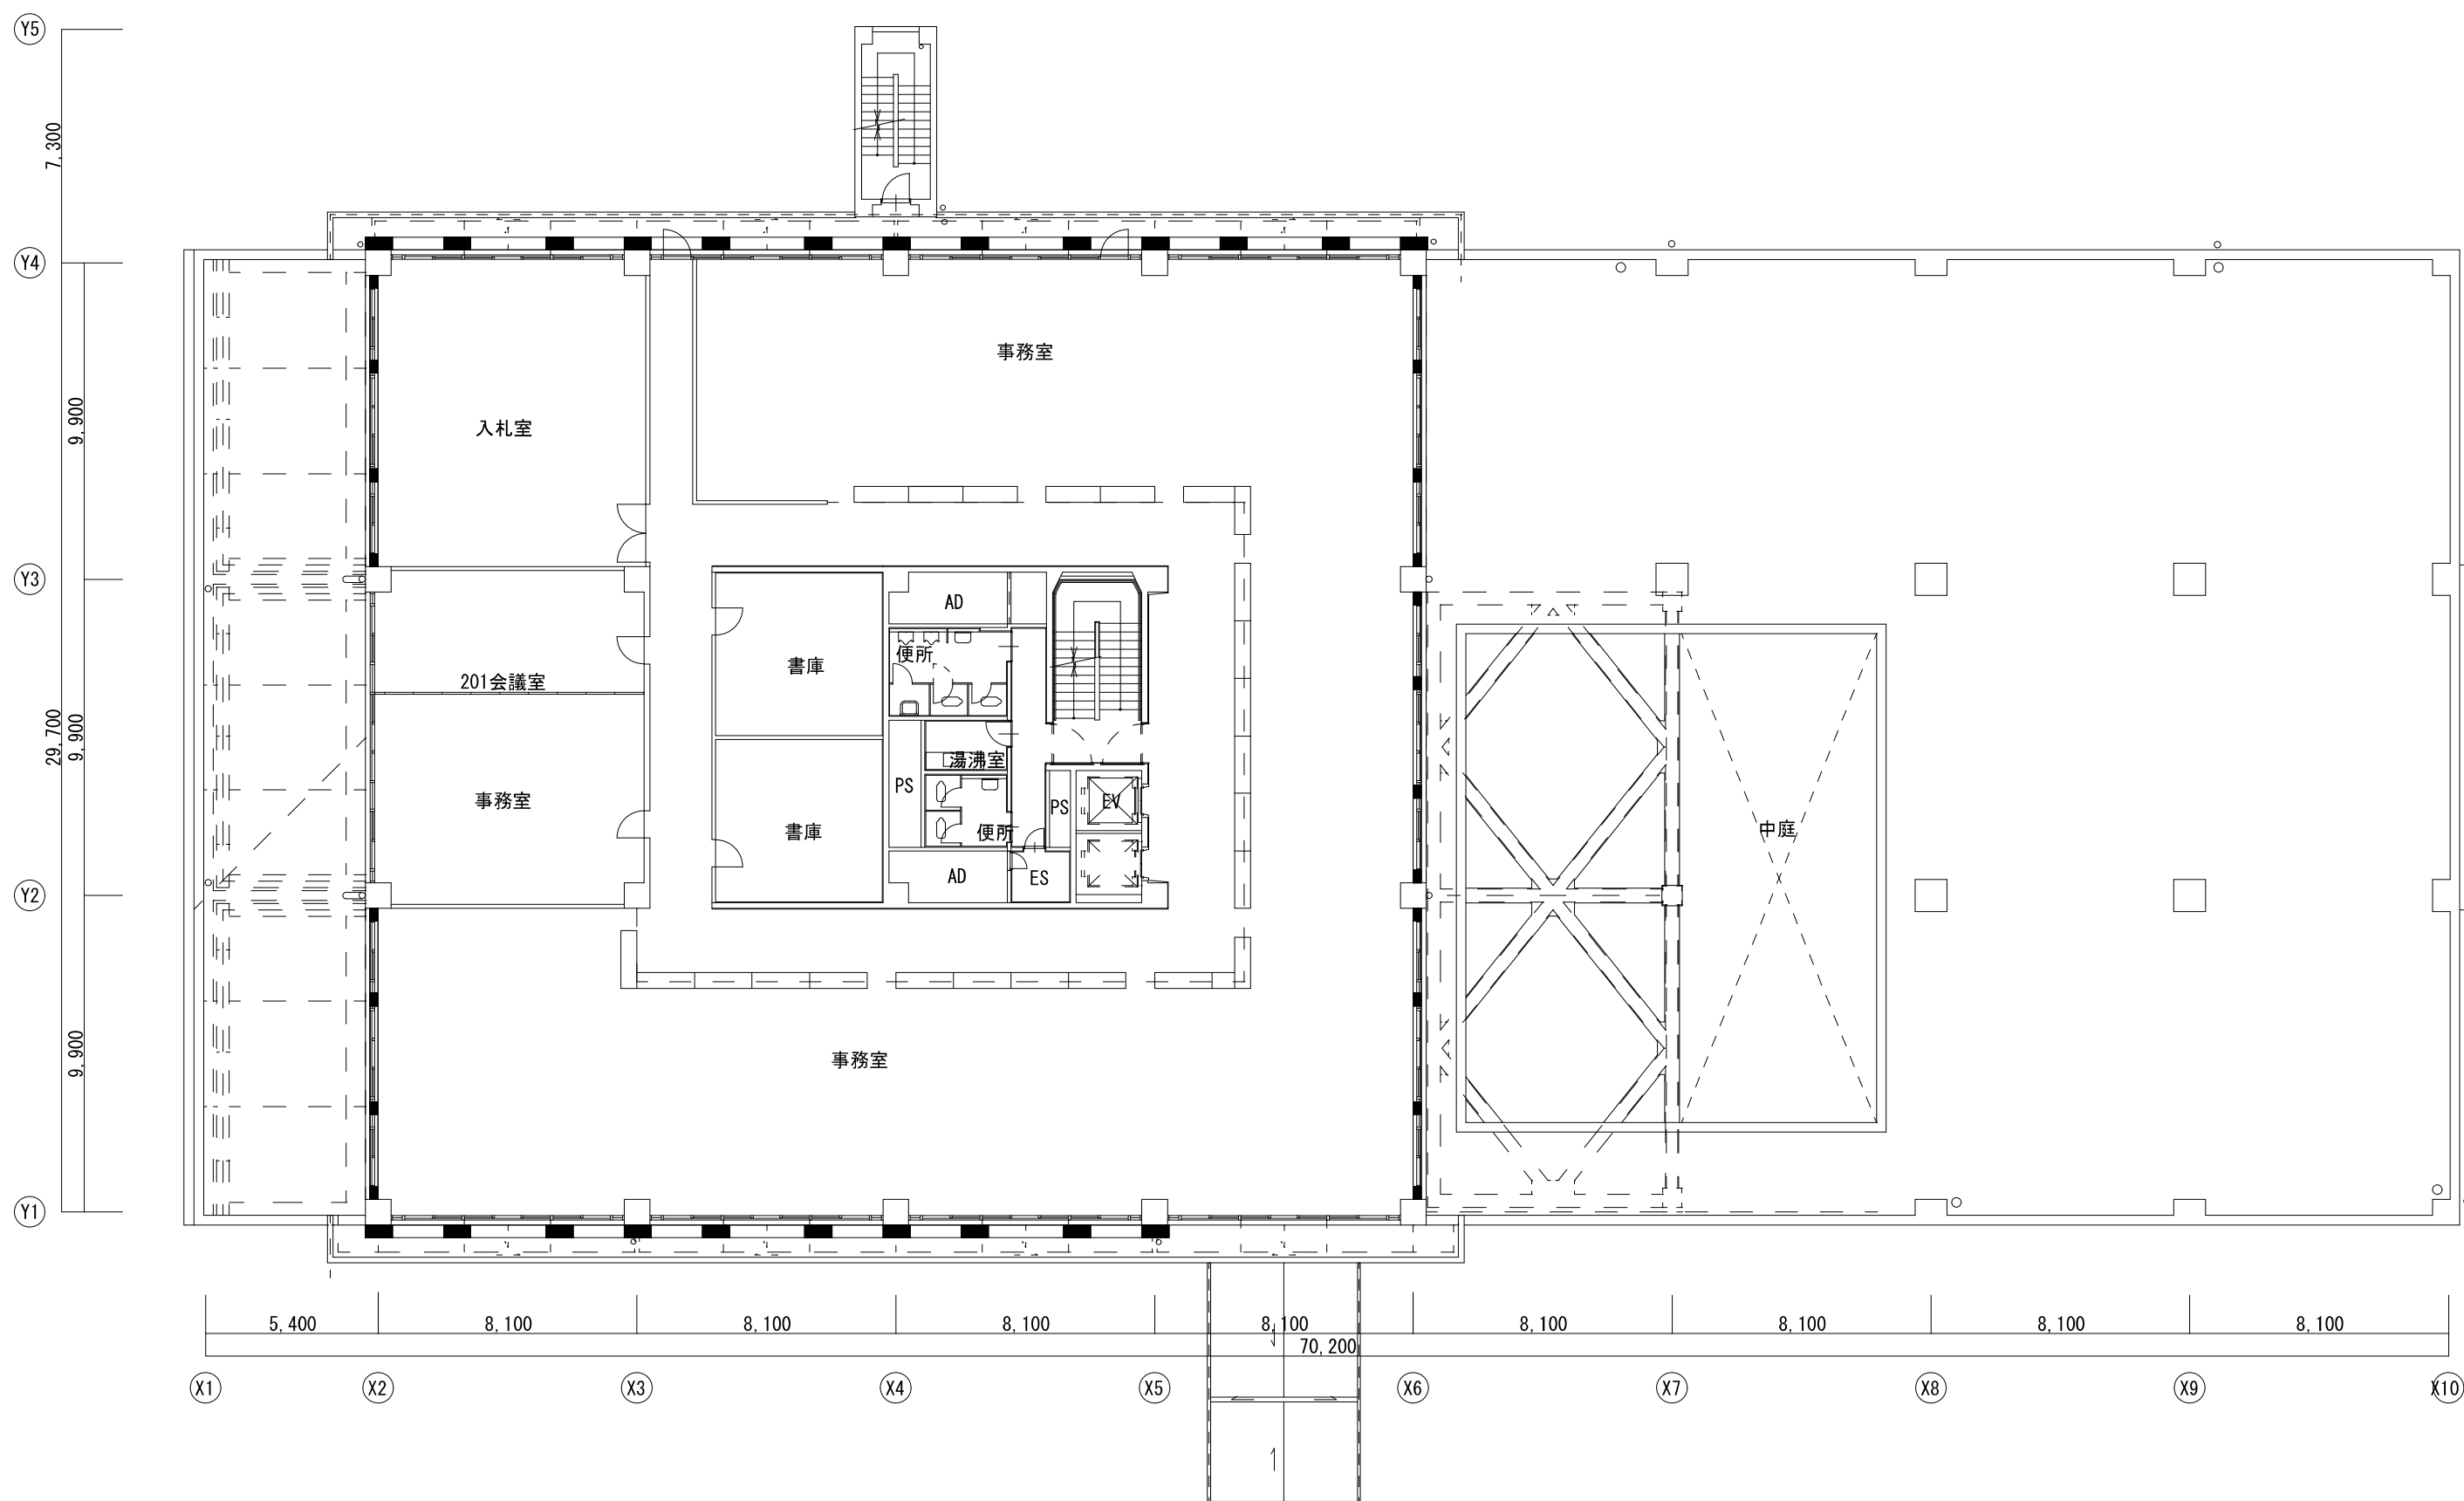


竣工図

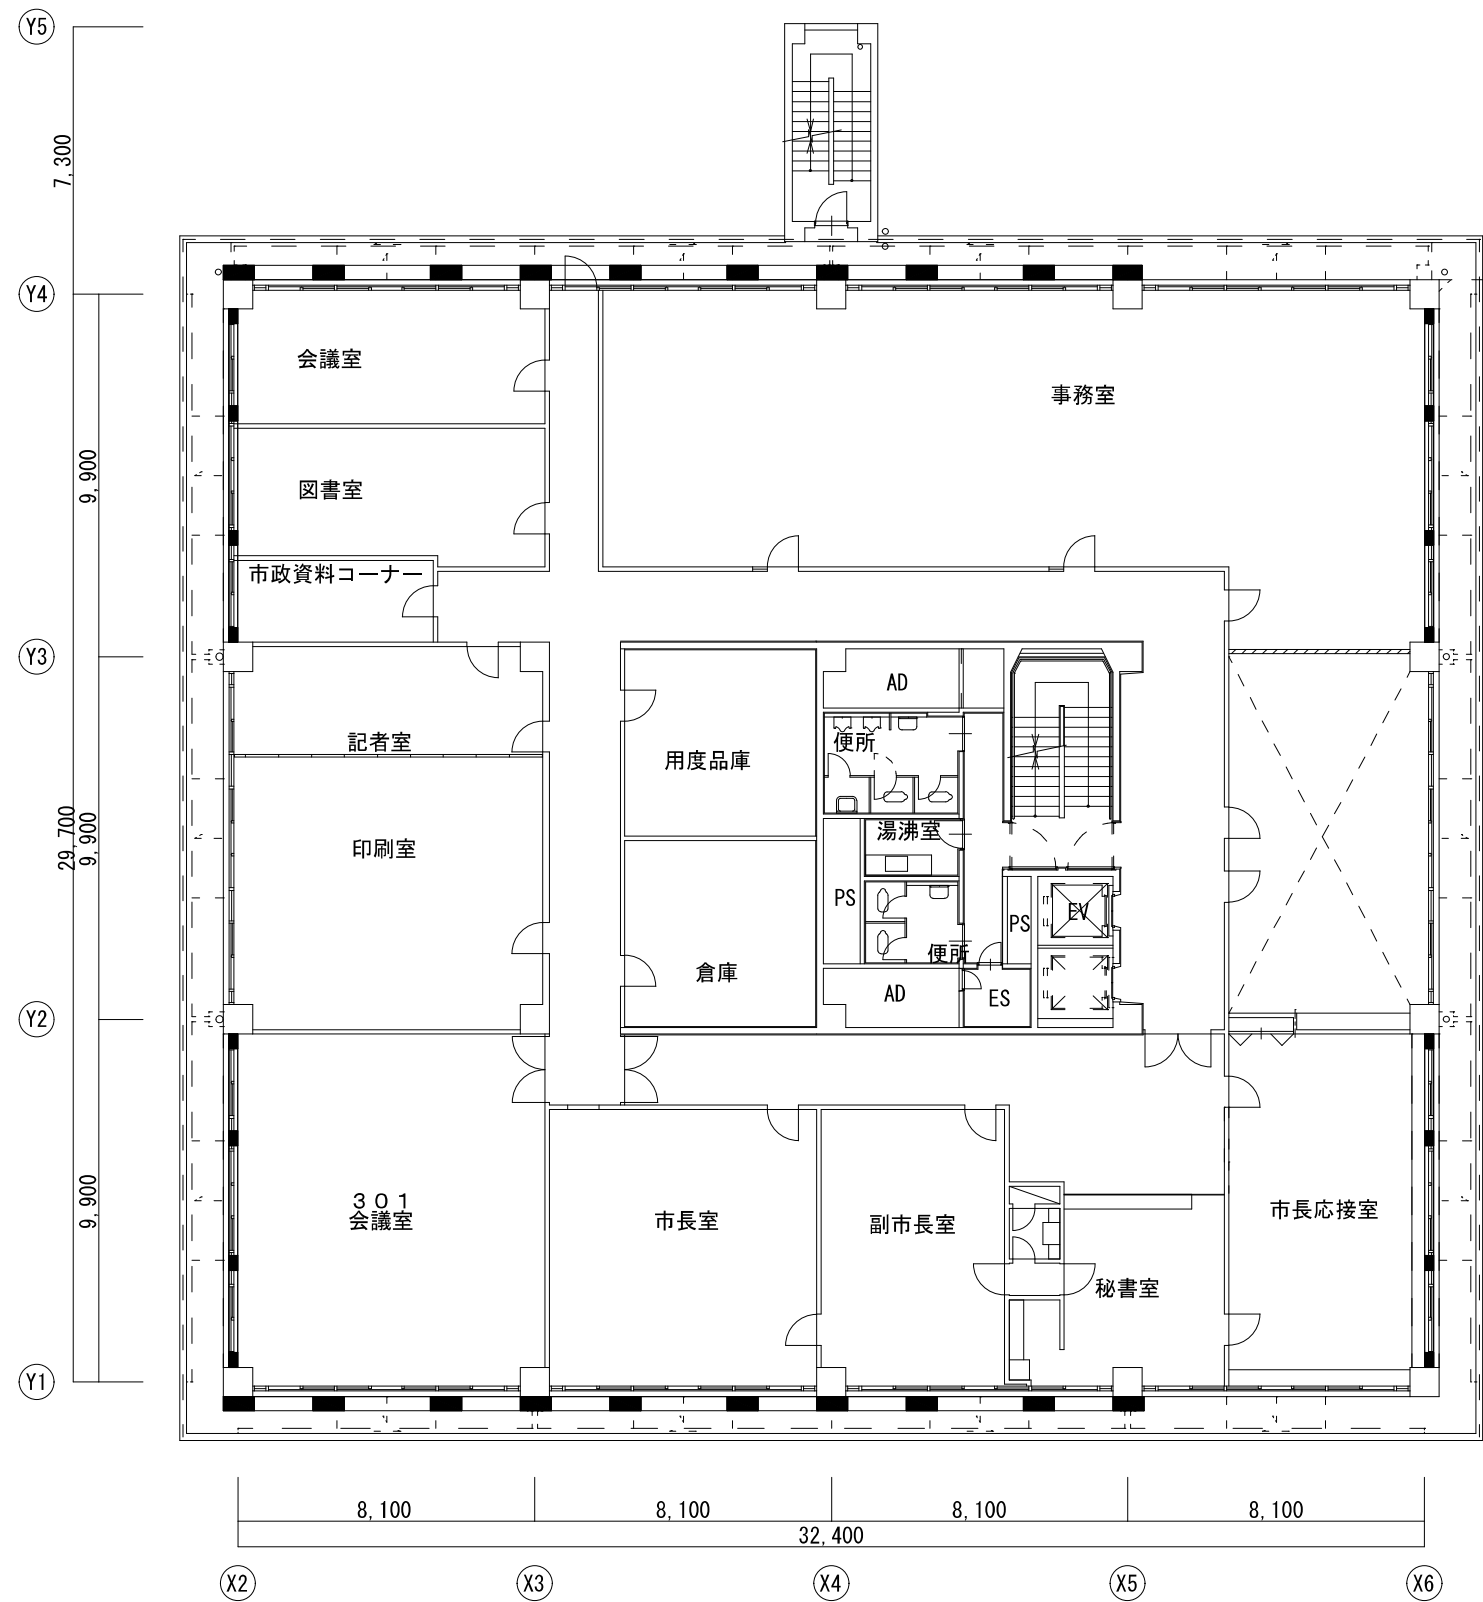


3階 平面図 S=1/200


竣工図

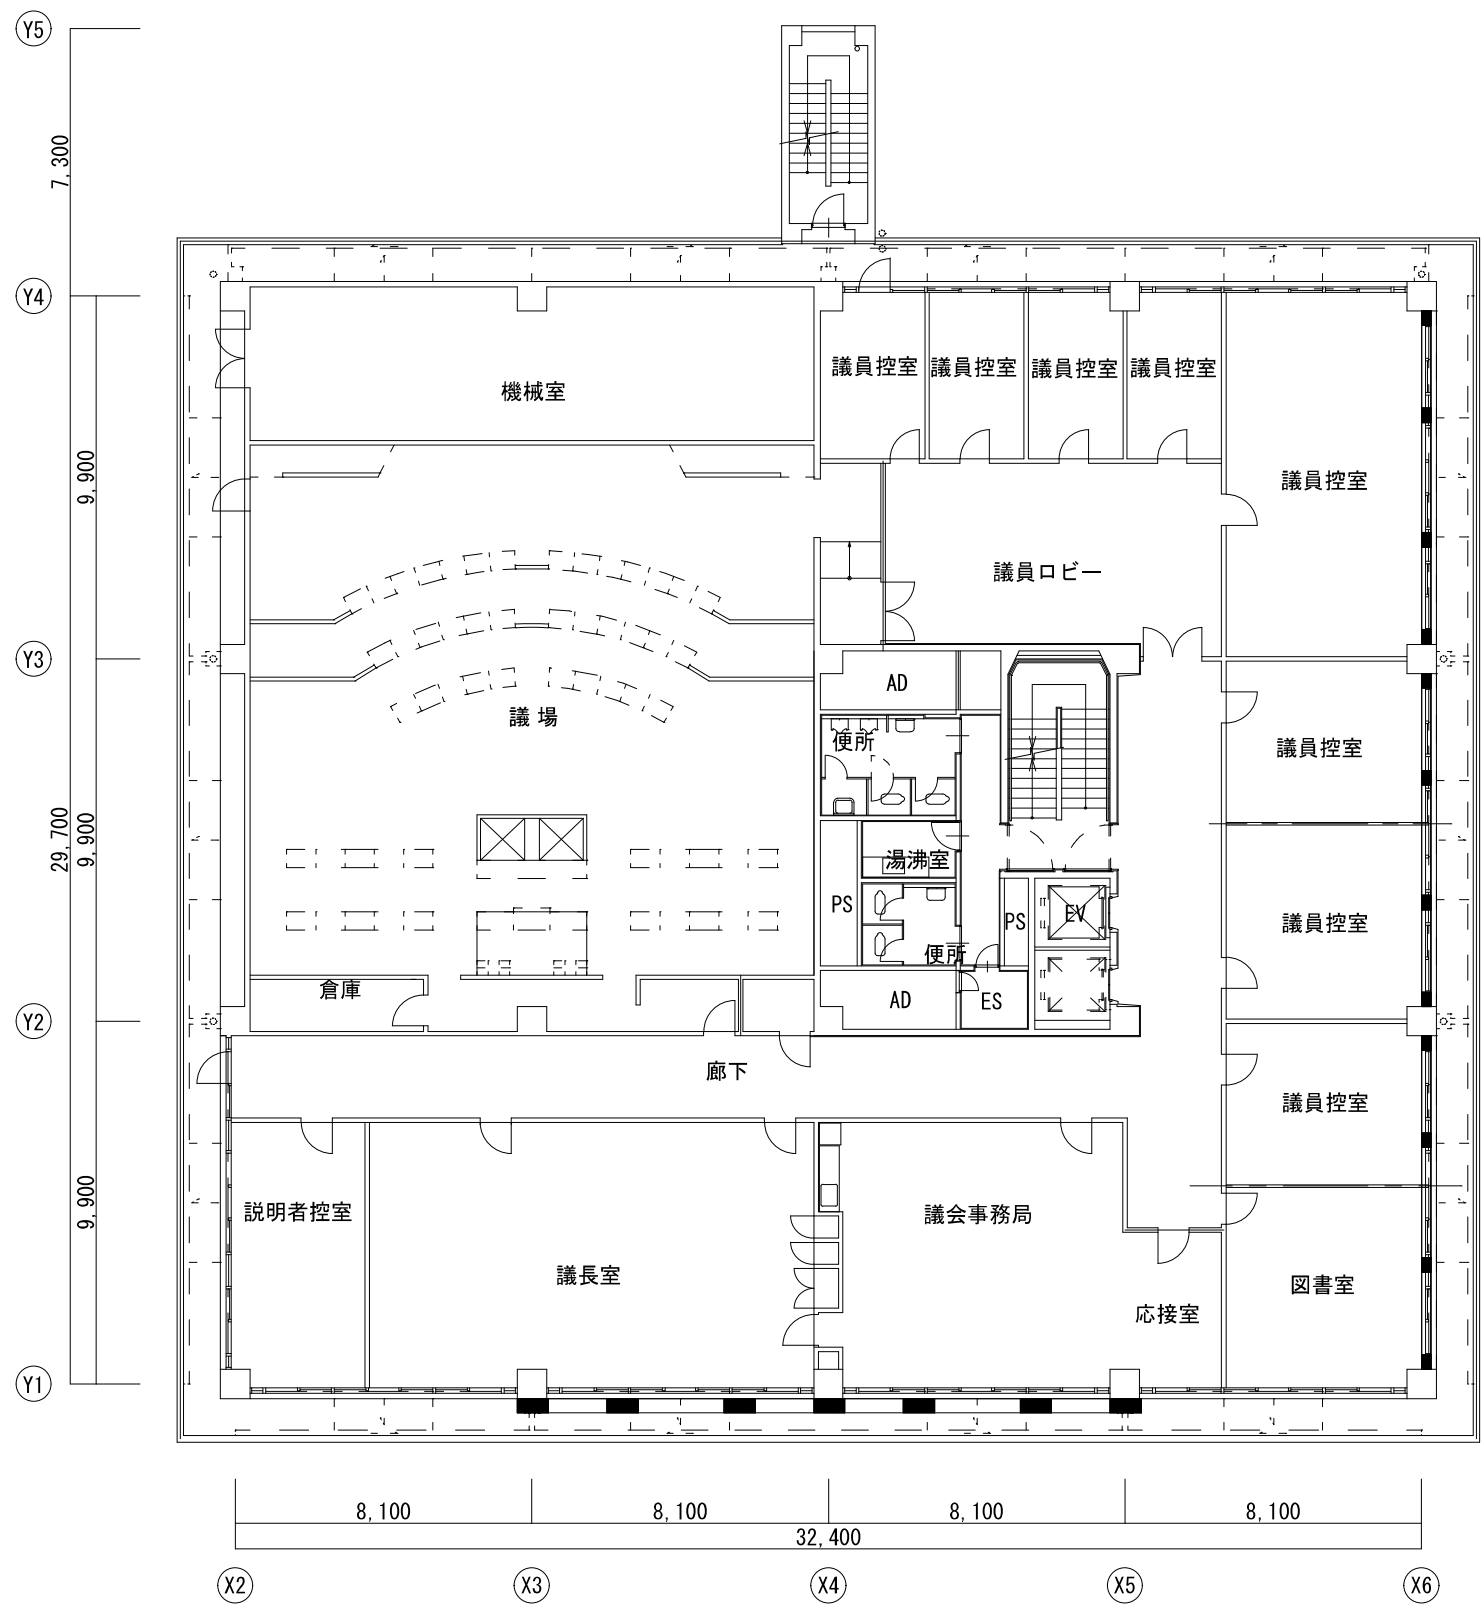

4階 平面図 S=1/200

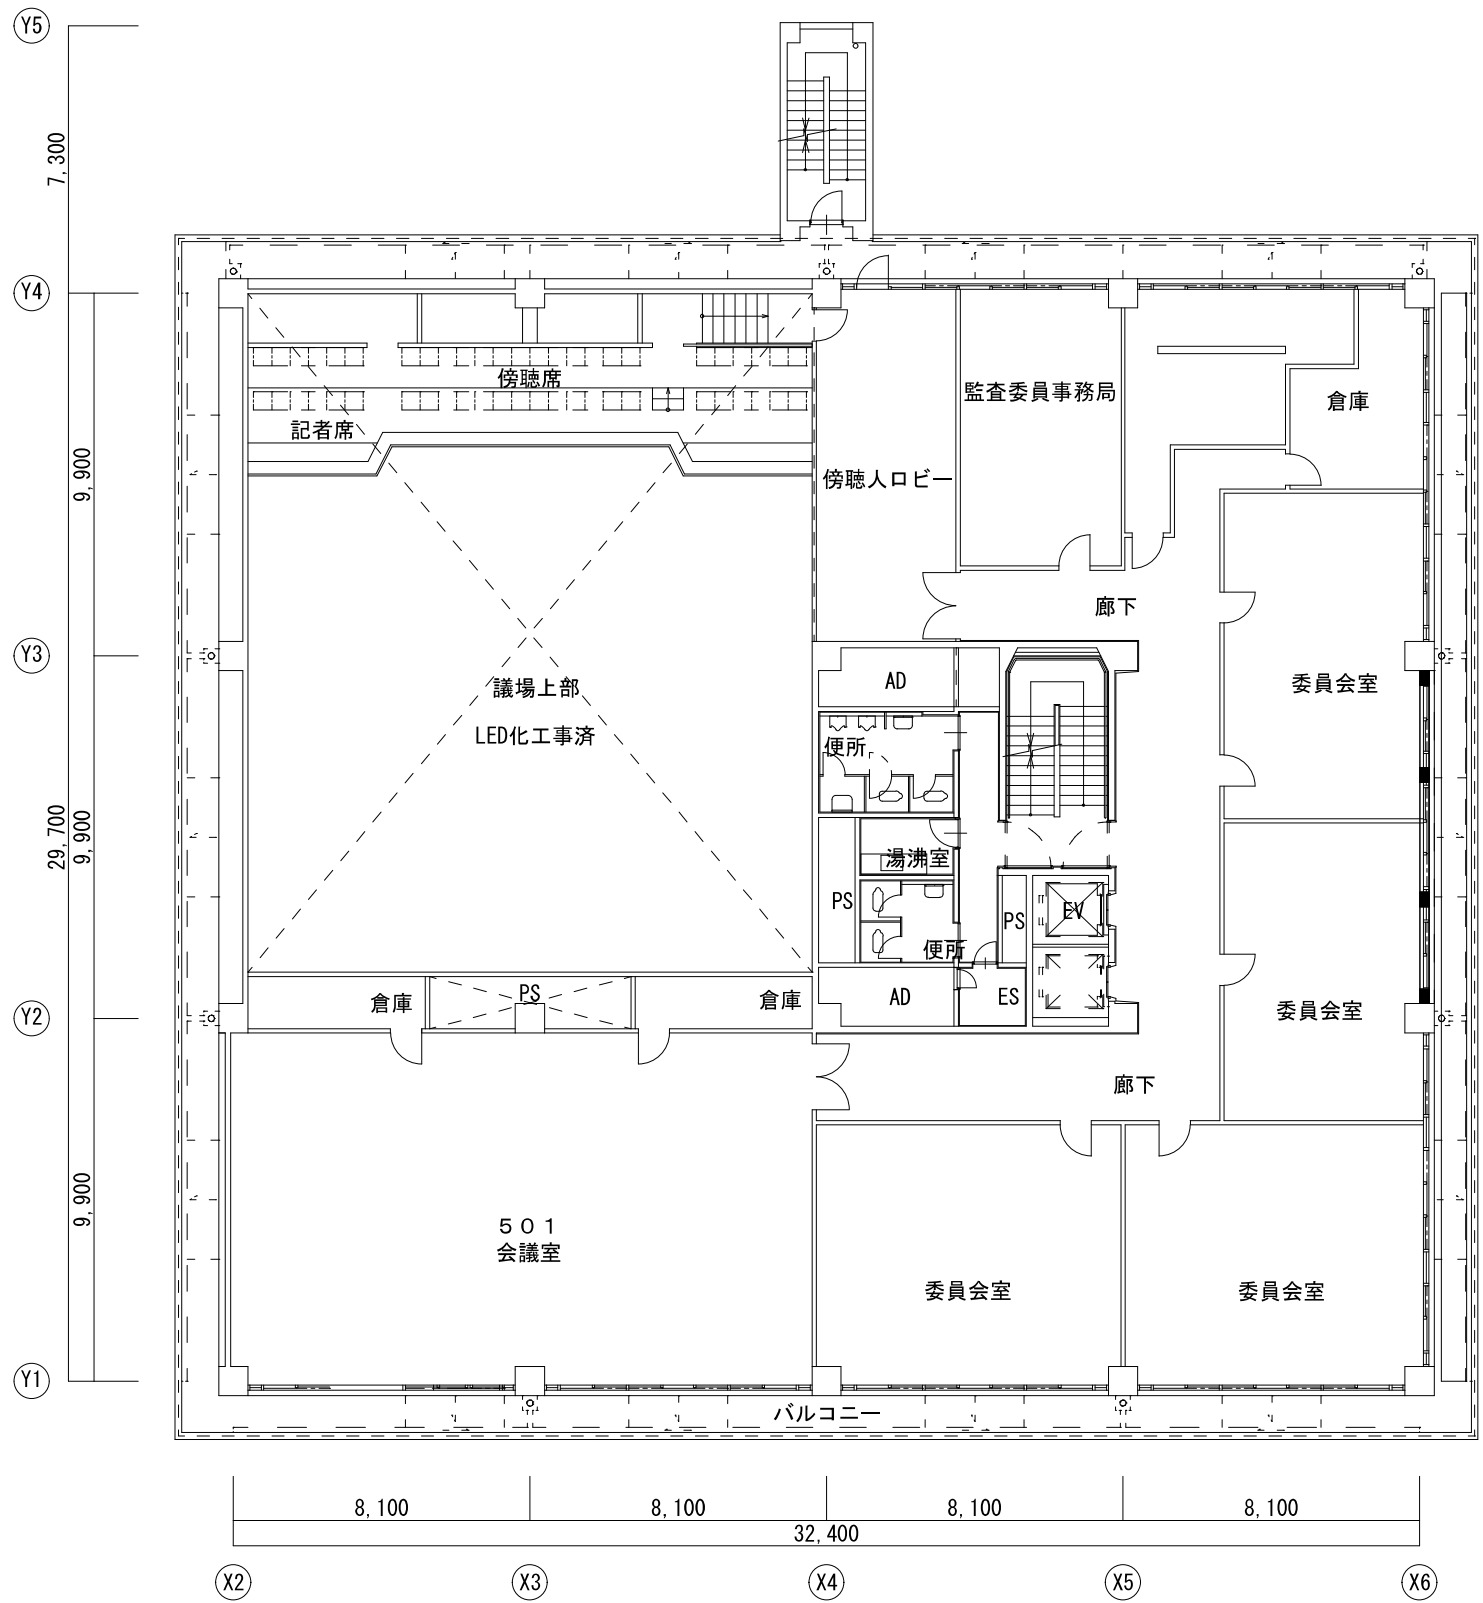

5階 平面図 S=1/200

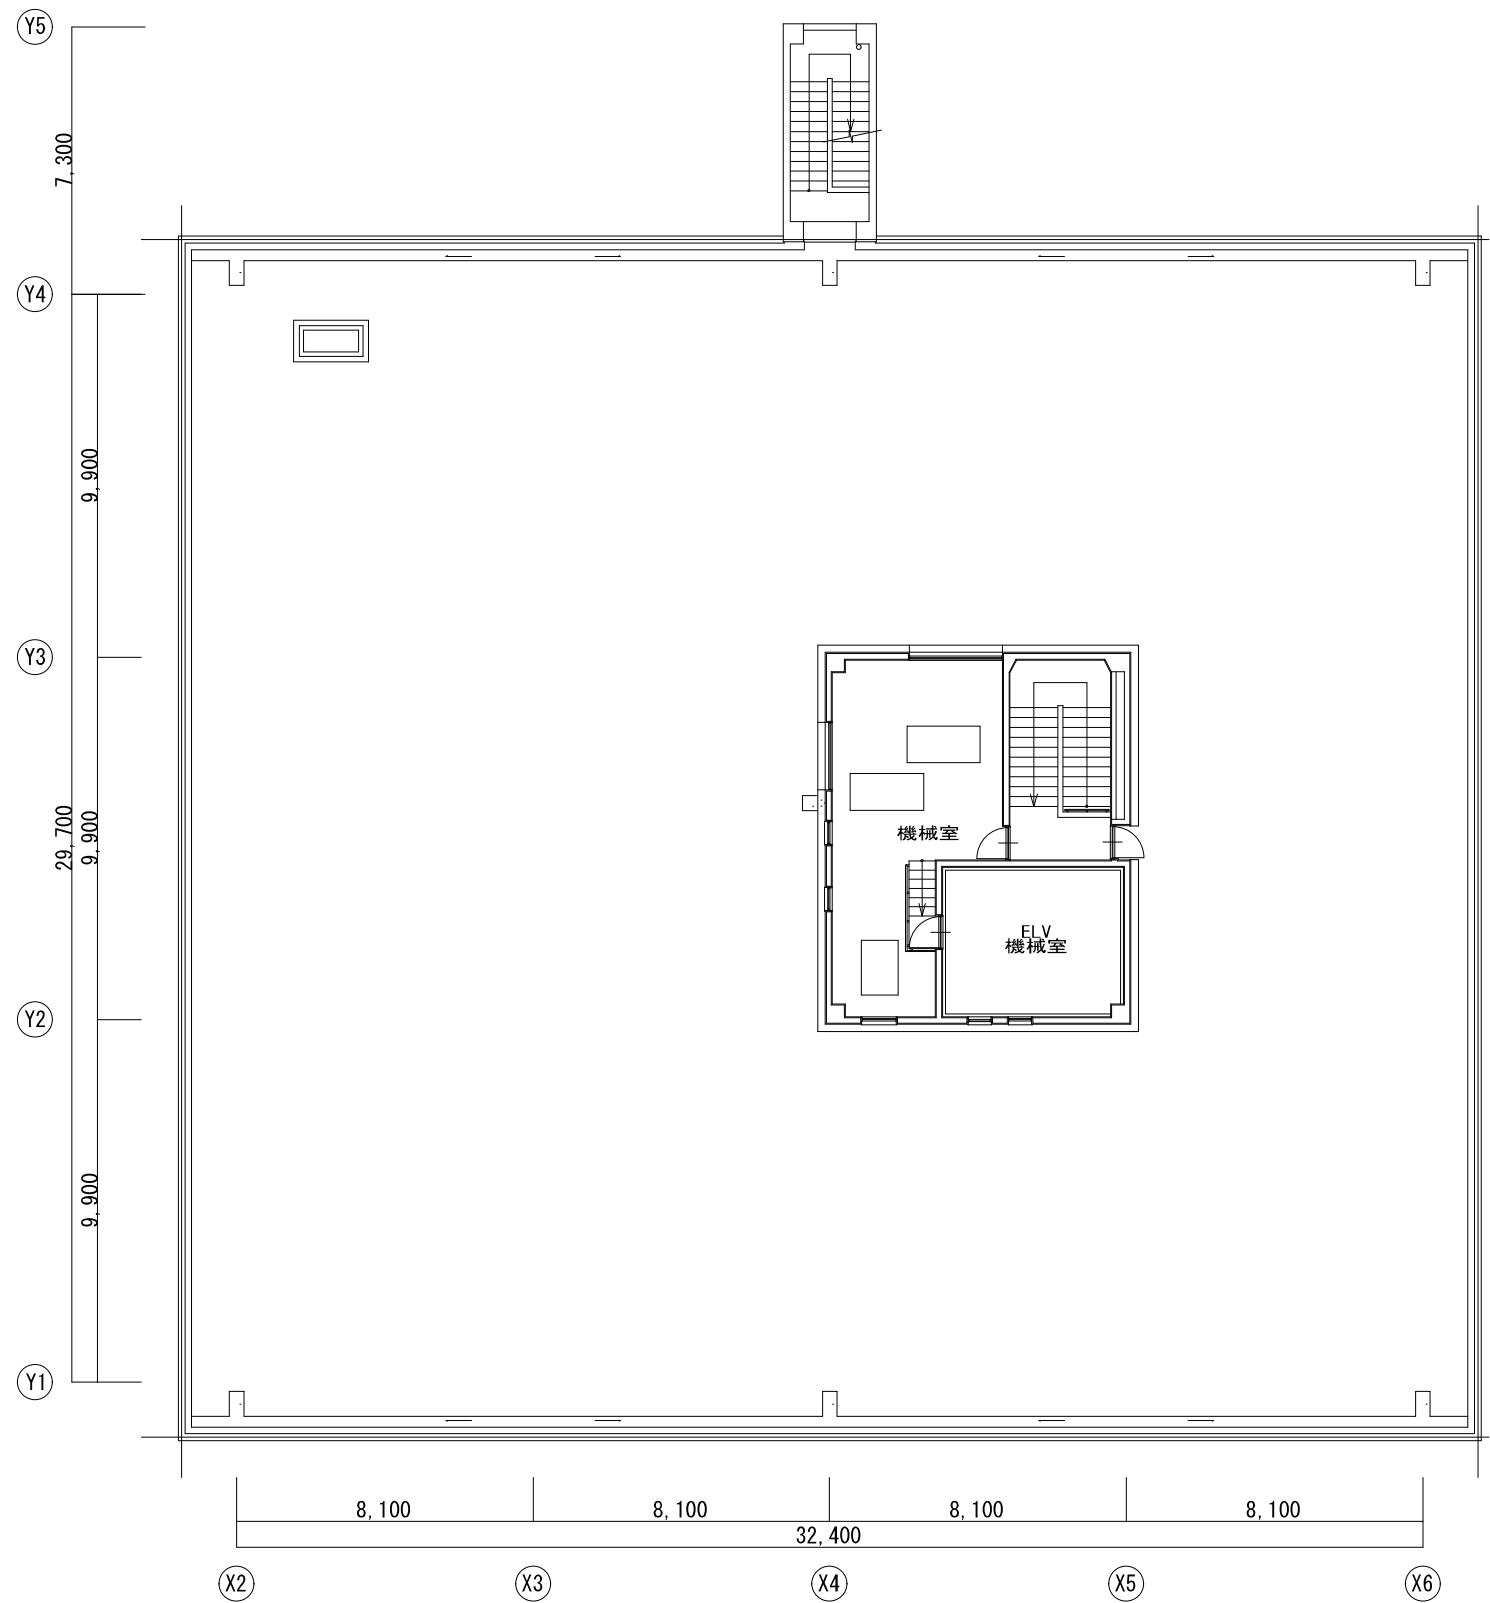

R階 平面図 S=1/200